

LEGEND

- STAGE BOUNDARY
- STORMWATER NEW
- STORMWATER EXISTING
- STORMWATER ABANDONED
- STORMWATER REMOVED
- CATCHPIT NEW
- EXISTING LOT BOUNDARIES

NOTES

- ALL CO-ORDINATES ARE IN TERMS OF NZTM.
- LEVELS ARE IN TERMS OF AUCKLAND 1946 (MSL) DATUM
- MANHOLES ARE 1050mmØ REINFORCED CONCRETE UNLESS SHOWN OTHERWISE.

APPLICATION NUMBERS:
ENG 60347110

CERTIFICATION

I CERTIFY THAT THIS AS-BUILT DRAWING IS AN ACCURATE RECORD OF THE WORKS UNDERTAKEN AND THAT:

- THE COORDINATES (X,Y) ARE IN TERMS OF NZTM ON NZGD(2000), AND ARE WITHIN ±50mm.
- THE LEVELS (Z) ARE IN TERMS OF THE AUCKLAND 1946 (MSL) LINZ DATUM (DOSLI), AND ARE WITHIN ±25mm.

SIGNED
LICENSED SURVEYOR

DATE: 03/06/2022
NAME: MATHEW BALSOM
ADDRESS: PO BOX 28-345, REMUERA AUCKLAND
CONTACT PHONE: (09) 579 5505
EMAIL: matthew.balsom@candor3.co.nz

REV	DESCRIPTION	BY	APPVD	DATE
-	INITIAL ISSUE	WJ	MB	17-05-22
A	SWMH 1/6; UPDATED MANHOLE Ø	WJ	MB	24-05-22
B	EPA NUMBER AMENDED	WJ	MB	3-06-22



PROJECT
MANGERE WEST STAGE 1E AS-BUILT STORMWATER (SHEET 1 OF 3)

CLIENT

PURPOSE		
AS-BUILT		
DESIGN DRAWN CHECK	MH WJ TL	APPROVED BY DATE MAY 2022
		SCALE 1:750 @ A3
PROJECT NO.	DRAWING NO.	REV.
1310s1E AB-400		B

STAGE 1E



LEGEND

	STAGE BOUNDARY
	STORMWATER NEW
	STORMWATER EXISTING
	STORMWATER ABANDONED
	STORMWATER REMOVED
	CATCHPIT NEW
	EXISTING LOT BOUNDARIES

NOTES

1. ALL CO-ORDINATES ARE IN TERMS OF NZTM.
2. LEVELS ARE IN TERMS OF AUCKLAND 1946 (MSL) DATUM
3. MANHOLES ARE 1050mmØ REINFORCED CONCRETE UNLESS SHOWN OTHERWISE.

APPLICATION NUMBERS:
ENG 60347110

CERTIFICATION

I CERTIFY THAT THIS AS-BUILT DRAWING IS AN ACCURATE RECORD OF THE WORKS UNDERTAKEN AND THAT:

- THE COORDINATES (X,Y) ARE IN TERMS OF NZTM ON NZGD(2000), AND ARE WITHIN ±50mm.
- THE LEVELS (Z) ARE IN TERMS OF THE AUCKLAND 1946 (MSL) LINZ DATUM (DOSLI), AND ARE WITHIN ±25mm.

SIGNED

LICENSED SURVEYOR

DATE: 03/06/2022

NAME: MATHEW BALSOM

ADDRESS: PO BOX 28-345, REMUERA AUCKLAND

CONTACT PHONE: (09) 579 5505

EMAIL: mathew.balsom@candor3.co.nz

PIT ID	NORTHING	EASTING	LID LEVEL	MH Ø(mm)
OUTLET 1/1	5907951.09	1759860.59	2.01	
SWMH 1/2	5907942.20	1759860.77	3.91	1800
SWMH 1/3	5907931.81	1759858.48	4.21	1500
SWMH 1/4	5907914.22	1759836.99	4.77	1800
SWMH 1/5	5907907.36	1759818.32	4.67	1800
SWMH 1/6	5907911.26	1759778.98	4.85	1500
SWMH 1/7	5907925.30	1759754.04	5.04	1050
SWMH 2/1	5907927.28	1759861.85	4.31	1050
SWMH 3/1	5907921.92	1759783.65	4.99	1050
SWMH 4/1	5907899.69	1759815.00	4.89	1050
DCP 1-1	5907908.45	1759832.04	4.32	N/A

REV	DESCRIPTION	BY	APPVD	DATE
-	INITIAL ISSUE	WJ	MB	17-05-22
A	SWMH 1/6; UPDATED MANHOLE Ø	WJ	MB	24-05-22
B	EPA NUMBER AMENDED	WJ	MB	3-06-22

Candor³
ENGINEERING FOR LIFE

PROJECT

MANGERE WEST STAGE 1E
AS-BUILT
STORMWATER (SHEET 2 OF 3)

CLIENT





PURPOSE

AS-BUILT

DESIGN	MH	APPROVED	SCALE
DRAWN	WJ	BY	1:400 @ A3
CHECK	TL	DATE	MAY 2022

PROJECT NO.	DRAWING NO.	REV.
1310s1E	AB-401	B

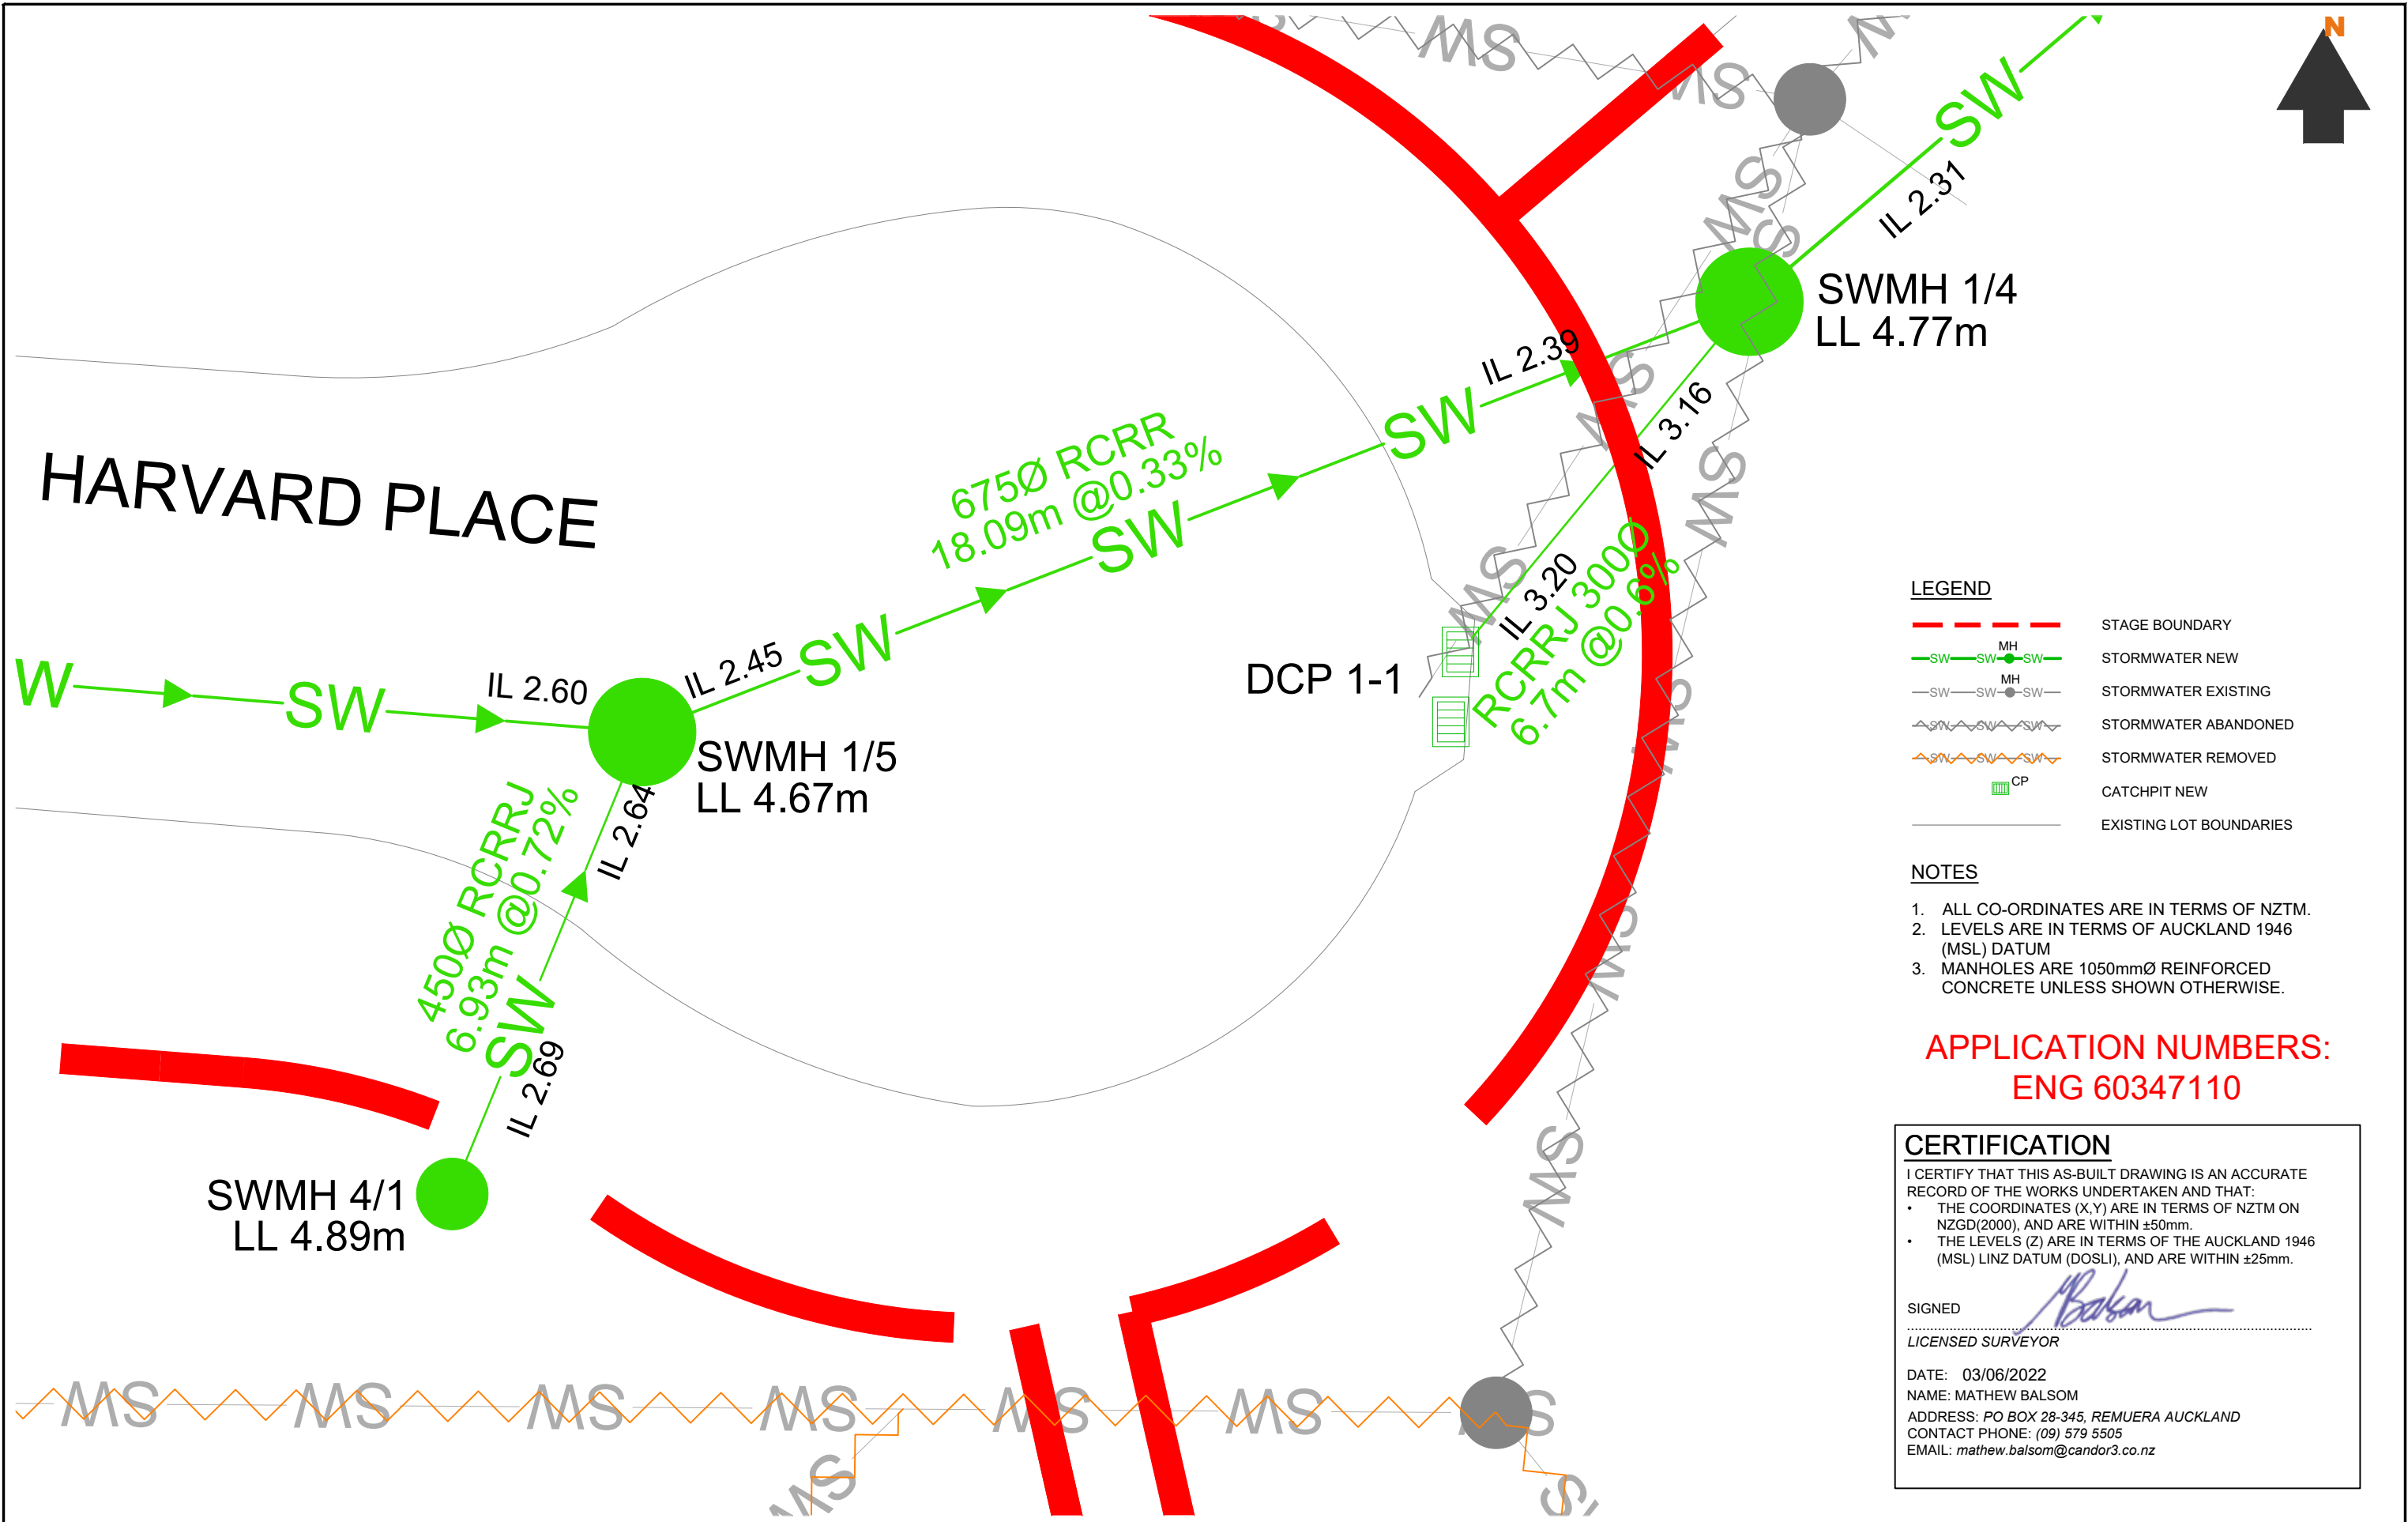

REV DESCRIPTION BY APPVD DATE					<div>Candor³</div> <div>ENGINEERING FOR LIFE</div>	PROJECT MANGERE WEST STAGE 1E AS-BUILT STORMWATER (SHEET 3 OF 3)	CLIENT <div> Kāinga Ora Homes and Communities</div>	PURPOSE AS-BUILT					
-	INITIAL ISSUE	WJ	MB	17-05-22				DESIGN DRAWN CHECK	MH WJ TL	APPROVED BY DATE	SCALE 1:100 @ A3		
A	SWMH 1/6; UPDATED MANHOLE Ø	WJ	MB	24-05-22				PROJECT NO.				DRAWING NO.	REV.
B	EPA NUMBER AMENDED	WJ	MB	3-05-22				1310s1E AB-402				B	